

**Public Works Committee Meeting**  
**Tuesday, June 7, 2022 5:00 PM**  
**Crete City Hall**  
**243 E 13th Street**  
**Crete, NE 68333**

**1. Open Meeting**

- In accordance with Nebraska law, a copy of the Open Meetings Act can be found in the back of the Council Chambers.
- Items listed on the agenda may be considered in any order.

**2. Roll Call**

- Attendance of members will be recorded to determine the presence of a quorum for official actions.

**3. Items of Business**

- The Committee may discuss or limit discussion on, hear testimony in favor of or in opposition to, or take action to provide a recommendation to the City Council on any matter presented under this title.
- 3.A. Provide a recommendation to the City Council on approving Windstream Nebraska's application for a permit to occupy the right-of-way at 2429 County Road F for fiber placement.
- 3.B. Provide a recommendation to the City Council on approving the bid of \$63,682.20 from Phil Carkowski for the water filter plant.
- 3.C. Discuss paving North Boswell Avenue.


**4. Officers' Reports**

- Reports may be given by the Mayor, Officers, Departments, or Councilmembers concerning the current operations of the City.
- No action can be taken on matters presented under this title except to answer any questions or to refer the matter for further action.

**5. Adjournment**

**Disclaimers & Notices**

- The Council may enter into closed session to discuss any matter on this agenda when it is determined that a closed session is clearly necessary for the protection of the public interest or the prevention of needless injury to the reputation of an individual (if such individual has not requested a public meeting) or as otherwise allowed by law. Any closed session shall be limited to the subject matter for which the closed session was called. If the motion to close passes, then immediately prior to the closed session the Mayor shall restate on the record the limitation of the subject matter of the closed session.
- The City of Crete assures that no person shall on the grounds of race, color, national origin, age, disability, handicap or sex, be excluded from participation in, be denied the benefits of, or be otherwise subjected to discrimination under any program or activity of the City receiving Federal financial assistance. To report discrimination, contact the City Clerk's office.
- The complete agenda with attachments is available at [www.crete.ne.gov](http://www.crete.ne.gov).

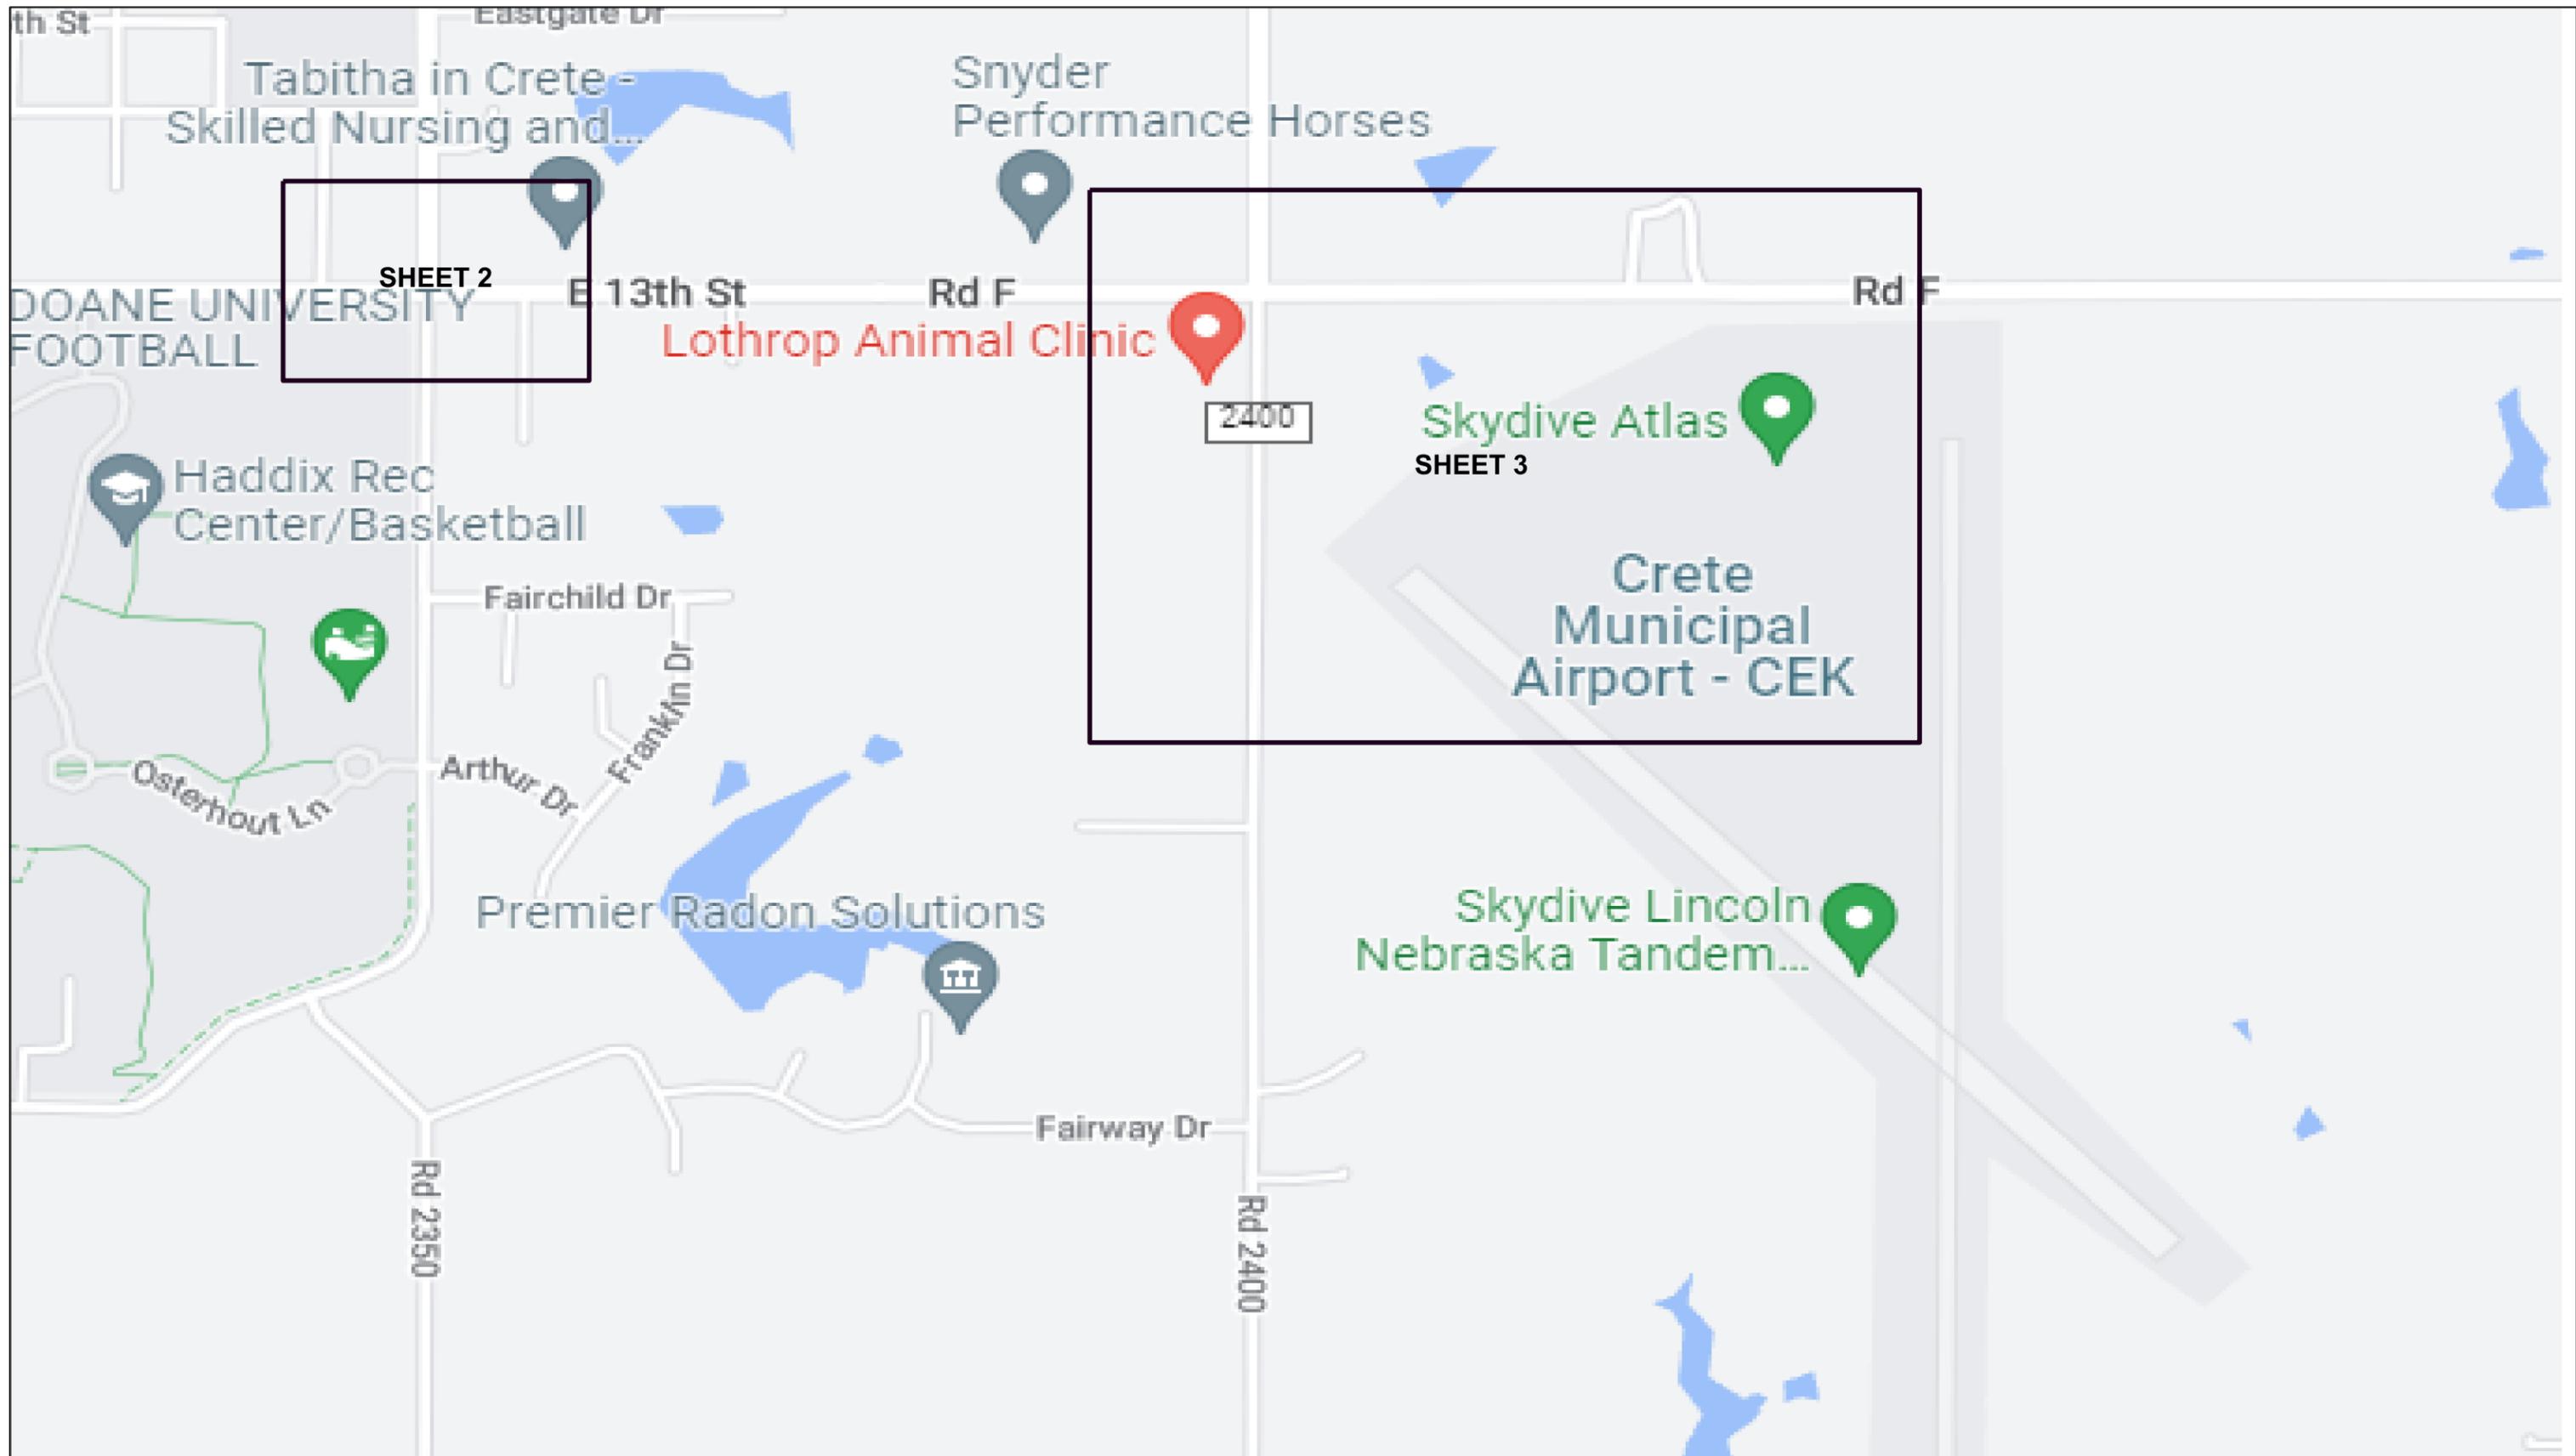

<b>FTBB:</b> N/A	<b>Job Description:</b> Fiber Service to 2429 County Road F, Crete, NE
<b>AWGF:</b> N/A	Air Methods Corp & Elevate Air Services, LLC
<b>Geo Block:</b> NECRET	<b>Project Manager:</b> Jake McNealy
<b>Tax District:</b> 0005	<b>Operations Manager:</b>
<b>Requested By:</b> Customer	


<b>Customer/Other Contacts:</b> RICK WETHEIMER 252-931-0222 SHAUN KRZYCKI 402-310-6124
<b>Circuit ID:</b> IP/L2XX/262884/ WINW/ IP/L1XX/301280/ WINW/

<b>Work Order #:</b> 7150221670000
<b>Date:</b> 5/13/22
<b>Engineer:</b> Jake McNealy <b>Phone No:</b> 402-890-7551

<b>Exchange:</b> CRET <b>District:</b> NE-1 Nebraska
<b>Revision #:</b> 0
<b>Revision Date:</b> NA <b>Sheet 1 Of 4</b>

<b>Cut Sheet Req:</b> N
<b>Permit Req:</b> Y
<b>MOP Req:</b> Y
<b>Joint Work Req:</b> N



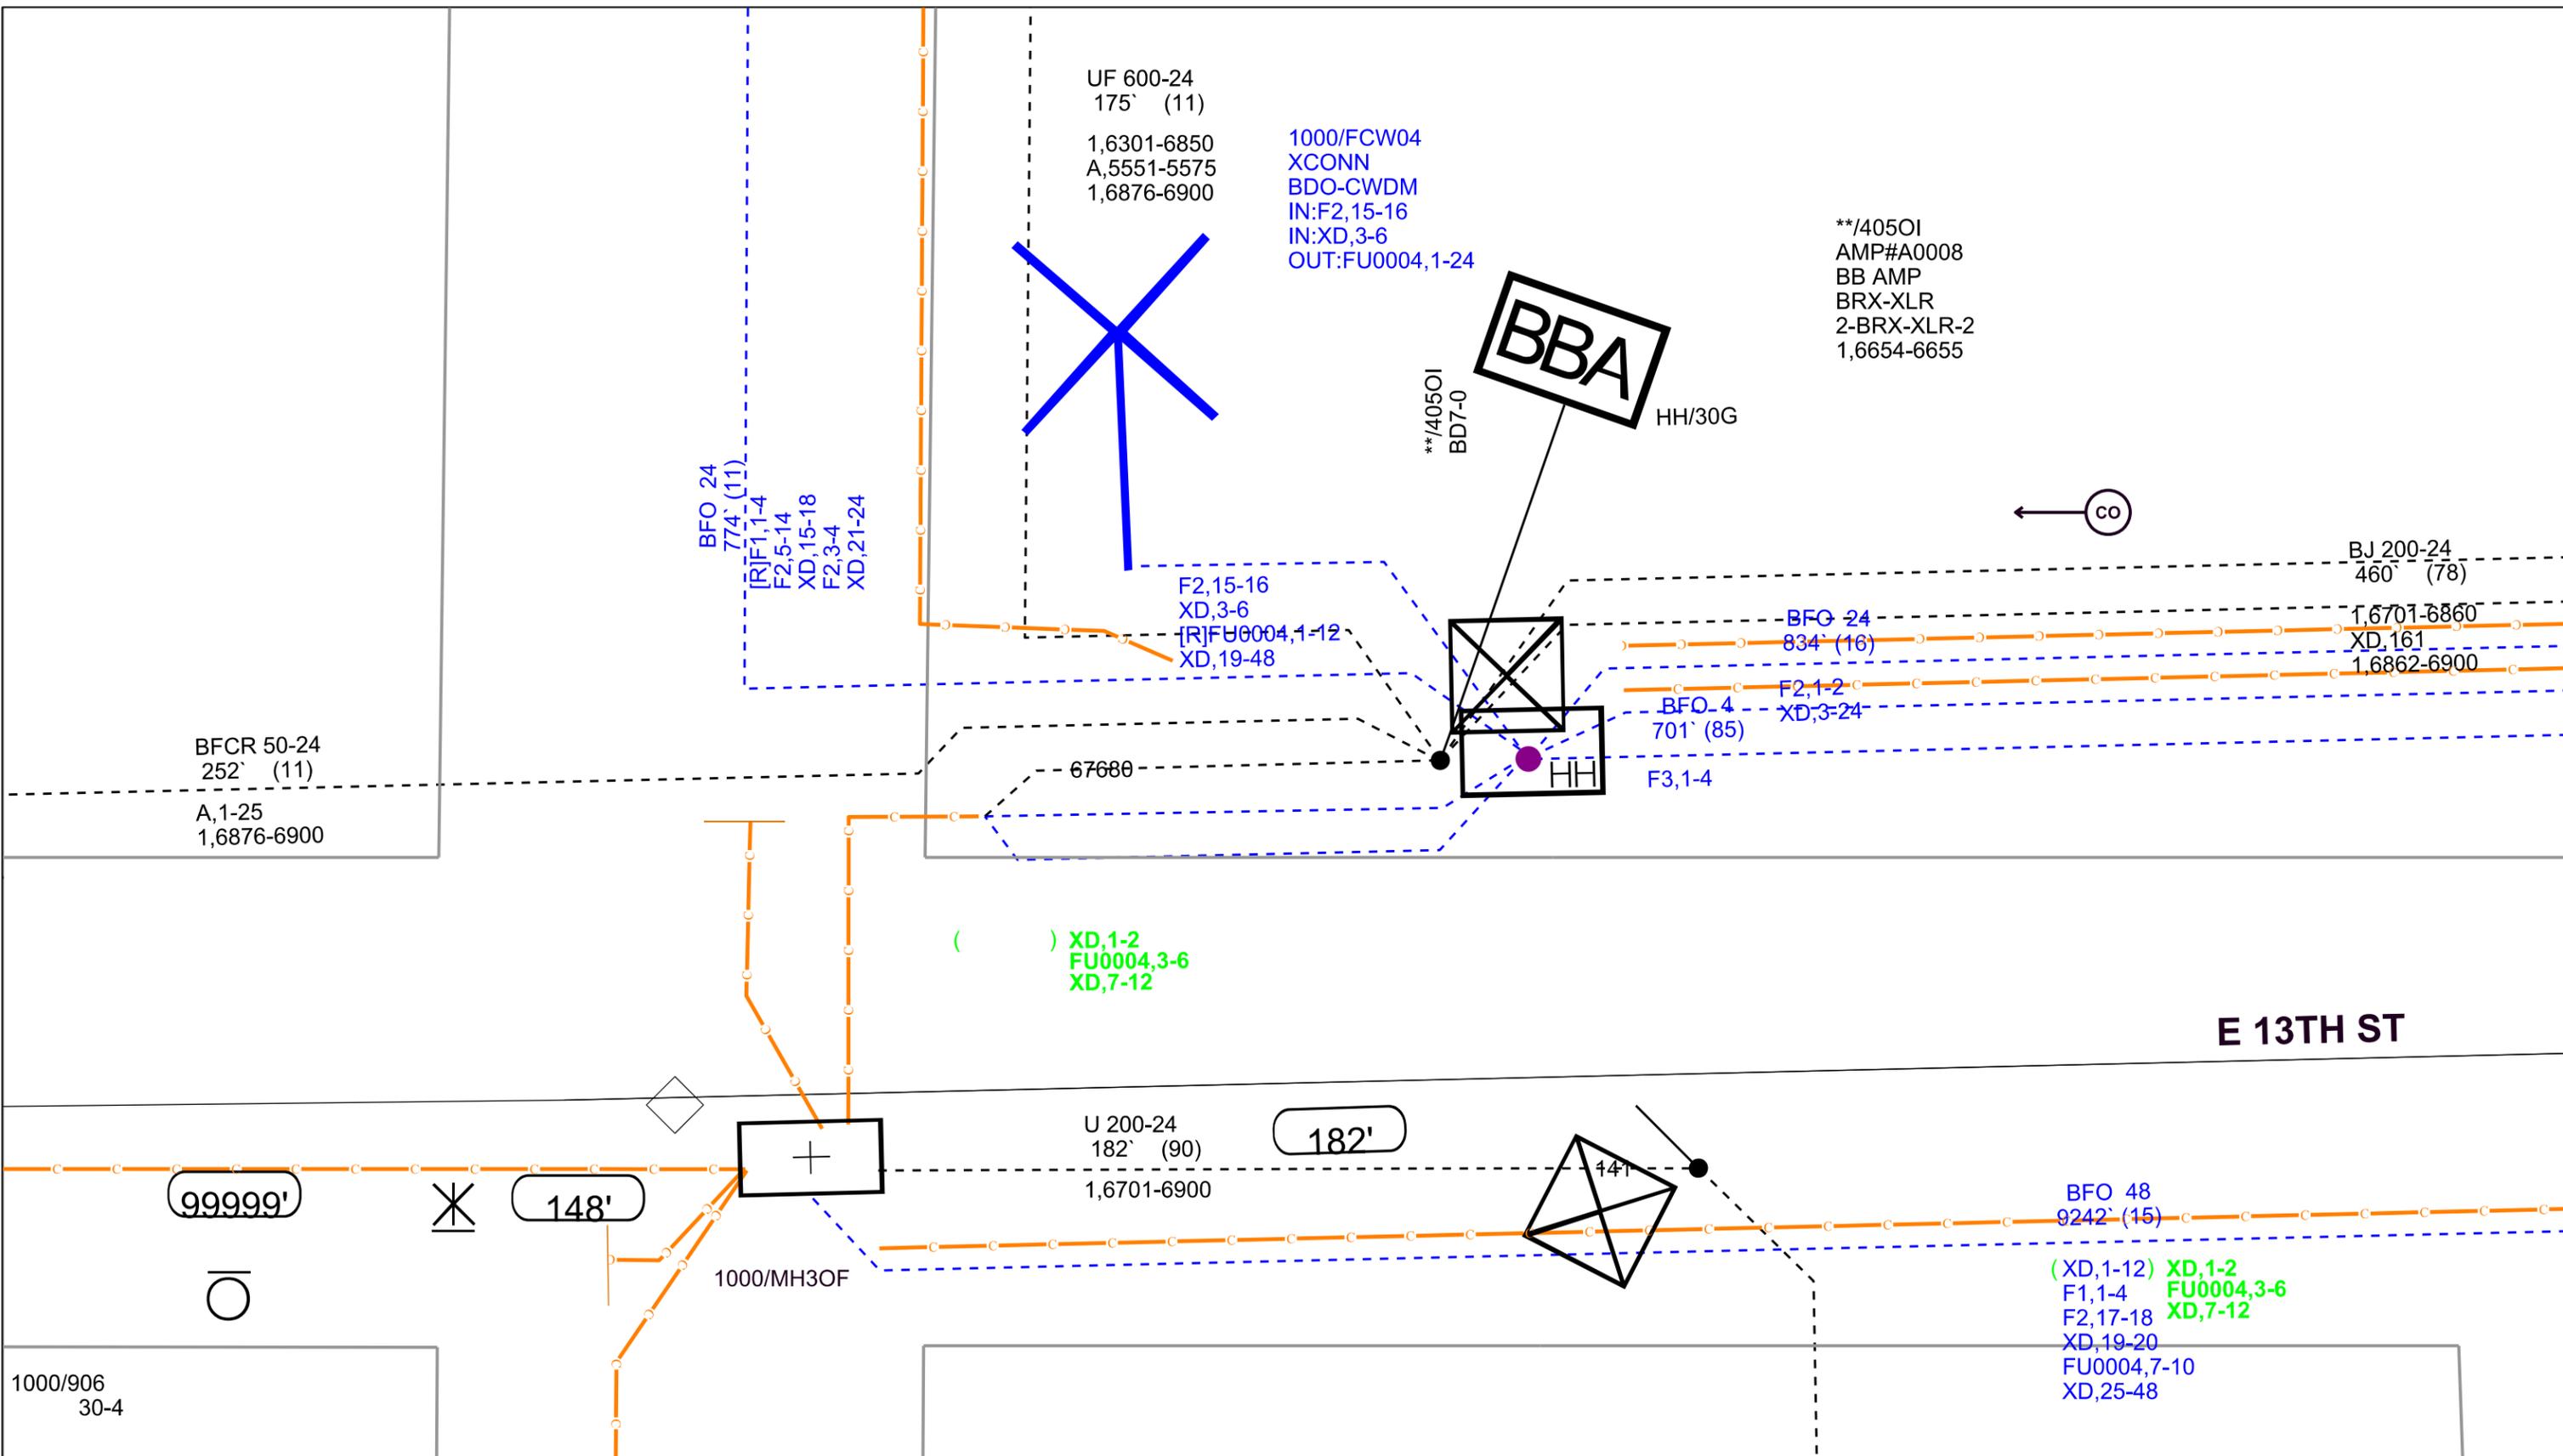

**FTBB:** N/A  
**AWGF:** N/A  
**Geo Block:** NECRET  
**Tax District:** 0005  
**Requested By:** Customer

**Job Description:**  
 Fiber Service to 2429 County Road F, Crete, NE  
 Air Methods Corp & Elevate Air Services, LLC  
**Project Manager:** Jake McNealy  
**Operations Manager:**


**Customer/Other Contacts:**  
**RICK WETHEIMER**  
 252-931-0222  
**SHAUN KRZYCKI**  
 402-310-6124  
**Circuit ID:** IP/L2XX/262884/ WINW/  
 IP/L1XX/301280/ WINW/

**Work Order #:** 7150221670000  
**Date:** 5/13/22  
**Engineer:** Jake McNealy  
**Phone No:** 402-890-7551

**Exchange:** CRET  
**District:** NE-1 Nebraska  
**Revision #:** 0  
**Revision Date:** NA  
**Sheet 2 Of 4**

**Cut Sheet Req:** N  
**Permit Req:** Y  
**MOP Req:** Y  
**Joint Work Req:** N



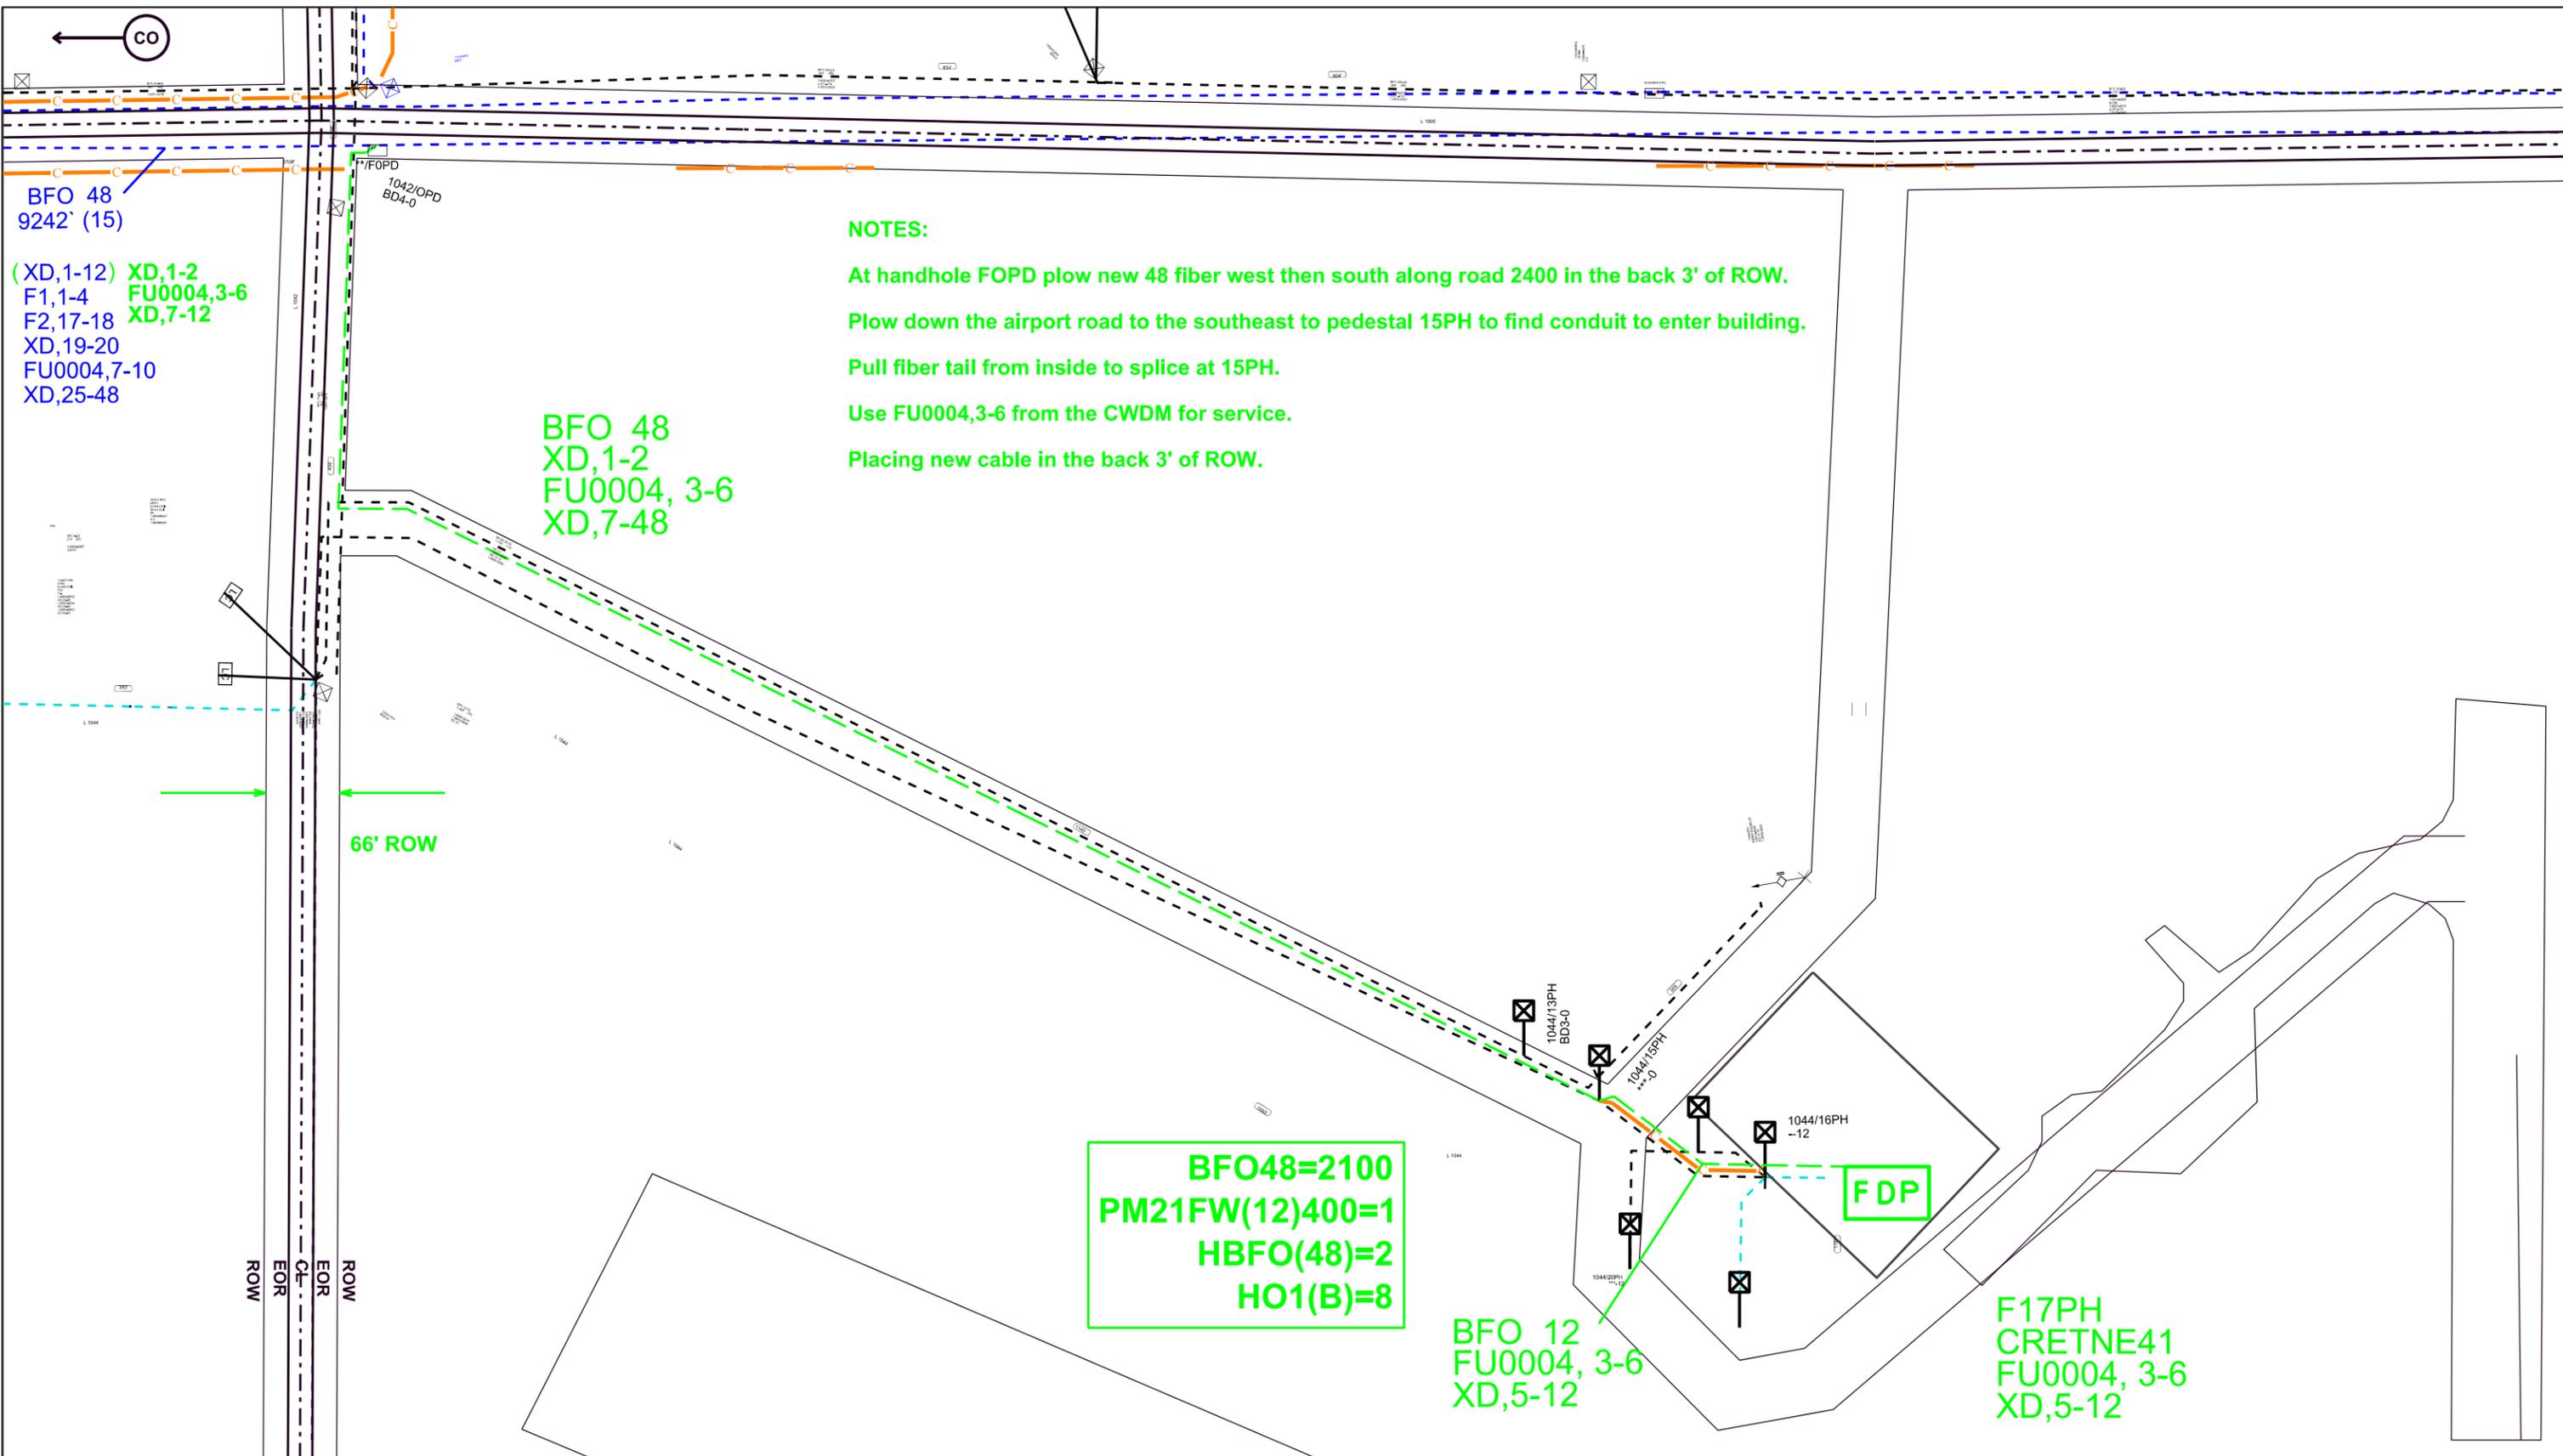

BFO 48  
9242' (15)

(XD,1-12) XG,1-2  
F1,1-4 FU0004,3-6  
F2,17-18 XG,7-12  
XD,19-20  
FU0004,7-10  
XD,25-48

BFO 48  
XD,1-2  
FU0004, 3-6  
XD,7-48

**NOTES:**

At handhole FOPD plow new 48 fiber west then south along road 2400 in the back 3' of ROW.

Plow down the airport road to the southeast to pedestal 15PH to find conduit to enter building.

Pull fiber tail from inside to splice at 15PH.

Use FU0004,3-6 from the CWDM for service.

Placing new cable in the back 3' of ROW.

BFO48=2100  
PM21FW(12)400=1  
HBFO(48)=2  
HO1(B)=8

BFO 12  
FU0004, 3-6  
XD,5-12

F17PH  
CRETNE41  
FU0004, 3-6  
XD,5-12

FTBB: N/A	<b>Job Description:</b> Fiber Service to 2429 County Road F, Crete, NE Air Methods Corp & Elevate Air Services, LLC	<b>Customer/Other Contacts:</b> RICK WETHEIMER 252-931-0222 SHAUN KRZYCKI 402-310-6124	<b>Work Order #:</b> 7150221670000	<b>Exchange:</b> CRET <b>District:</b> NE-1 Nebraska	<b>Cut Sheet Req:</b> N
AWGF: N/A	<b>Project Manager:</b> Jake McNealy	<b>Circuit ID:</b> IP/L2XX/262884/ WINW/ IP/L1XX/301280/ WINW/	<b>Date:</b> 5/13/22	<b>Revision #:</b> 0	<b>Permit Req:</b> Y
Geo Block: NECRET	<b>Operations Manager:</b>		<b>Engineer:</b> Jake McNealy <b>Phone No:</b> 402-890-7551	<b>Revision Date:</b> NA	<b>MOP Req:</b> Y
Tax District: 0005				<b>Sheet 3 Of 4</b>	<b>Joint Work Req:</b> N
<b>Requested By:</b> Customer					





CWDM




FOPD



Airport Driveway



Conduit to building pedestal

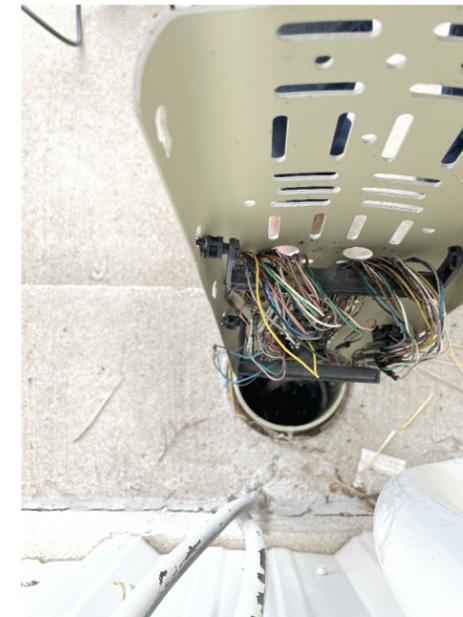

Conduit entering building

<b>FTBB:</b> N/A	<b>Job Description:</b> Fiber Service to 2429 County Road F, Crete, NE Air Methods Corp & Elevate Air Services, LLC	<b>Customer/Other Contacts:</b> RICK WETHEIMER 252-931-0222 SHAUN KRZYCKI 402-310-6124	<b>Work Order #:</b> 7150221670000	<b>Exchange:</b> CRET <b>District:</b> NE-1 Nebraska	<b>Cut Sheet Req:</b> N
<b>AWGF:</b> N/A	<b>Project Manager:</b> Jake McNealy		<b>Date:</b> 5/13/22	<b>Revision #:</b> 0	<b>Permit Req:</b> Y
<b>Geo Block:</b> NECRET	<b>Operations Manager:</b>		<b>Engineer:</b> Jake McNealy <b>Phone No:</b> 402-890-7551	<b>Revision Date:</b> NA	<b>MOP Req:</b> Y
<b>Tax District:</b> 0005		<b>Circuit ID:</b> IP/L2XX/262884/ WINW/ IP/L1XX/301280/ WINW/		<b>Sheet 4 Of 4</b>	<b>Joint Work Req:</b> N
<b>Requested By:</b> Customer					





243 East 13th Street  
P.O. Box 86  
Crete, NE 68333-  
0086

## Application for a Permit to Occupy City of Crete Right-of-Way

(Rev. 2, 11-2015)

I Windstream Nebraska, LLC hereby request to occupy City of Crete Right-of-  
Name

Way at 2429 County Road F with a device or structure.  
Address

Description of structure or device:

Fiber to 2429 County Road F, Crete, NE. Using existing CWDM at Iris Ave and 13th street. Start placing fiber at county road F and 2400, Handhole FOPD. Place fiber to building and place FDP inside. WO#71502216700000;PR-6609

- Diagram, or print included?
- Necessary permits and licenses obtained? Insurance?
- Approved by the Public Works Director \_\_\_\_\_ Date: \_\_\_\_\_

Note:

- 1) All applicants to occupy public right-of-way understand and agree that if, for any reason, the City or its agents require access; the obstruction shall be moved at the applicant's expense.
- 2) Any items approved for placement in the right-of-way shall be held to the building or property line as closely as possible.
- 3) If this is a 3rd party utility type project, all affected property owners shall be notified prior to the beginning of project by the project owner, or the project's contractor.
- 4) City Council approval is required for large projects (more than one property involved, or utility oriented projects).
- 5) All requests to occupy right-of-way must include a detailed sketch, print, or drawing with dimensions with respect to property lines, paving, curbs etc....
- 6) If this application is for underground sprinkler systems, a print or drawing of the system including location of lines and heads with measurements listed must accompany the application. Additionally, the applicant may be required to provide proof of proper permits to install, plumb, and provide backflow protection for said underground sprinkler systems.
- 7) Application for a permanent structure deemed to be a traffic or public safety hazard or which limit visibility will be denied.
- 8) An application shall be approved before any construction or installation is allowed to begin.

Melvin Fecher  
Signature of Applicant

05/16/2022  
Date of Application

**SUMMARY OF QUANTITIES  
ENGINEERS ESTIMATE  
NORTH BOSWELL AVENUE**

Project No.: Boswell Avenue C.N.: \_\_\_\_\_  
 Location: Crete  
 Consultant: Speece | Lewis Engineers  
 Estimate by: TWF Date: 5/25/2022

BID ITEMS	QUANTITY	UNITS	AVG. UNIT PRICE	TOTAL
<b>GRADING ITEMS</b>				
GENERAL CLEARING AND GRUBBING	1.00	LS	\$ 15,000.00	\$ 15,000.00
LARGE TREE REMOVAL	10.00	EACH	\$ 550.00	\$ 5,500.00
EARTHWORK MEASURED IN EMBANKMENT	2,200.00	CY	\$ 11.00	\$ 24,200.00
WATER, APPLIED	30.00	MGAL	\$ 30.00	\$ 900.00
COVERCROP SEEDING	3.00	ACRES	\$ 850.00	\$ 2,550.00
TEMPORARY SILT FENCE	300.00	LF	\$ 5.00	\$ 1,500.00
SILT CHECK, TYPE WATTLE	2,500.00	LF	\$ 5.00	\$ 12,500.00
EROSION CONTROL, CLASS 1D	15,000.00	SY	\$ 5.00	\$ 75,000.00
24" DRIVEWAY CULVERT PIPE, TYPE 2,3,4,5,6,7 OR 8	200.00	LF	\$ 75.00	\$ 15,000.00
MOBILIZATION	1.00	LS	\$ 15,000.00	\$ 15,000.00
			<b>GRADING TOTAL</b>	<b>\$ 167,150.00</b>
<b>PAVING ITEMS</b>				
9" CLASS 47B-3500 DOWELED CONCRETE PAVEMENT	7,688.00	SY	\$ 60.00	\$ 461,280.00
4" FOUNDATION COURSE	7,688.00	SY	\$ 10.00	\$ 76,880.00
SUBGRADE PREPARATION	7,688.00	SY	\$ 3.50	\$ 26,908.00
EARTH SHOULDER CONSTRUCTION	48.00	STA	\$ 320.00	\$ 15,360.00
PREPARATION OF INTERSECTIONS & DRIVEWAYS	800.00	SY	\$ 6.00	\$ 4,800.00
WATER	34.00	MGAL	\$ 30.00	\$ 1,020.00
9" CLASS 47B-3500 CONCRETE DRIVEWAY	800.00	SY	\$ 100.00	\$ 80,000.00
CONCRETE FOR HEADERS, CLASS 47B-3500	3.00	CY	\$ 450.00	\$ 1,350.00
SPECIAL SURFACE COURSE FOR MAILBOX TURNOUTS	20.00	SY	\$ 55.00	\$ 1,100.00
MAILBOX SUPPORT POST	2.00	EACH	\$ 300.00	\$ 600.00
PERMANENT PAVEMENT MARKING	7,500.00	LF	\$ 0.50	\$ 3,750.00
MOBILIZATION	1.00	LS	\$ 50,000.00	\$ 50,000.00
			<b>PAVING TOTAL</b>	<b>\$ 669,298.00</b>
<b>GENERAL ITEMS</b>				
RENTAL OF LOADER, FULLY OPERATED	10.00	HOURS	\$ 95.00	\$ 950.00
RENTAL OF DUMP TRUCK, FULLY OPERATED	10.00	HOURS	\$ 75.00	\$ 750.00
RENTAL OF SKID LOADER, FULLY OPERATED	10.00	HOURS	\$ 95.00	\$ 950.00
RENTAL OF CRAWLER MOUNTED HYDRAULIC EXCAVATOR, FULLY OPERATED	10.00	HOURS	\$ 100.00	\$ 1,000.00
			<b>GENERAL TOTAL</b>	<b>\$ 3,650.00</b>
			<b>CONSTRUCTION TOTAL</b>	<b>\$ 840,098.00</b>
			<b>CONSTRUCTION ENGINEERING</b>	<b>\$ 100,000.00</b>
			<b>PRELIMINARY ENGINEERING</b>	<b>\$ 63,000.00</b>
			<b>RIGHT OF WAY AND UTILITIES</b>	<b>\$ 35,000.00</b>
			<b>GRAND TOTAL</b>	<b>\$ 975,098.00</b>